



GT50/15/0004

**ROAD TRAFFIC REGULATION ACT 1984 – SECTIONS 64 AND 65
AUTHORISATION OF TRAFFIC SIGNS AND SPECIAL DIRECTIONS**

The Secretary of State for Transport, in exercise of his powers under Sections 64 and 65 of the Road Traffic Regulation Act 1984, and of all other powers enabling him in that behalf, for the purpose of informing road users of the conditions of use of a bus gate in Quay Street, Bristol, hereby:-

1. authorises the erection at the sites marked with an orange cross on the attached plan numbered GT50/15/0004-1 of a traffic sign (hereinafter referred to as “the authorised sign”) conforming as to size, colour and character with that shown on the attached drawing numbered NP 953B; and
2. directs that the authorised sign shall only be used with the plate shown in diagram 953.2 in Schedule 5 to the Traffic Signs Regulations 2002 (Part I of SI 2002/3113, “the 2002 Regulations”); and
3. directs that it is a condition of this authorisation that the authorised sign may be placed only to indicate the effect of a corresponding Traffic Regulation Order; and
4. directs, without prejudice to any statutory provision to the like effect, that it is a condition of this authorisation that the erection of the authorised sign at or near the said sites shall continue to have effect only until such day as may be appointed by one month’s notice given by the Secretary of State in writing to the traffic authority for the removal or alteration of the authorised sign and on that day the said authorisation shall, without prejudice to the giving of any further authorisation or direction, cease to have effect.

 


GT50/15/0004

The provisions of Regulations 12, 18 and 19 of the 2002 Regulations shall apply to the authorised sign in the same manner as they apply to the sign shown in diagram 953 in Schedule 5 to those Regulations.

Dated.....*21 June*.....2011

Signed by authority of the Secretary of State







.....
A Delegated Official of the Department for Transport

CERTIFIED TRUE COPY

4/7/11



DEPARTMENT FOR TRANSPORT

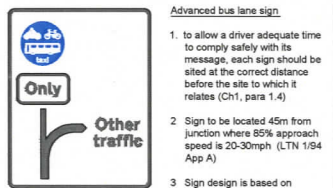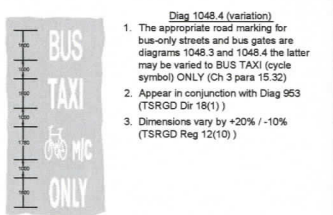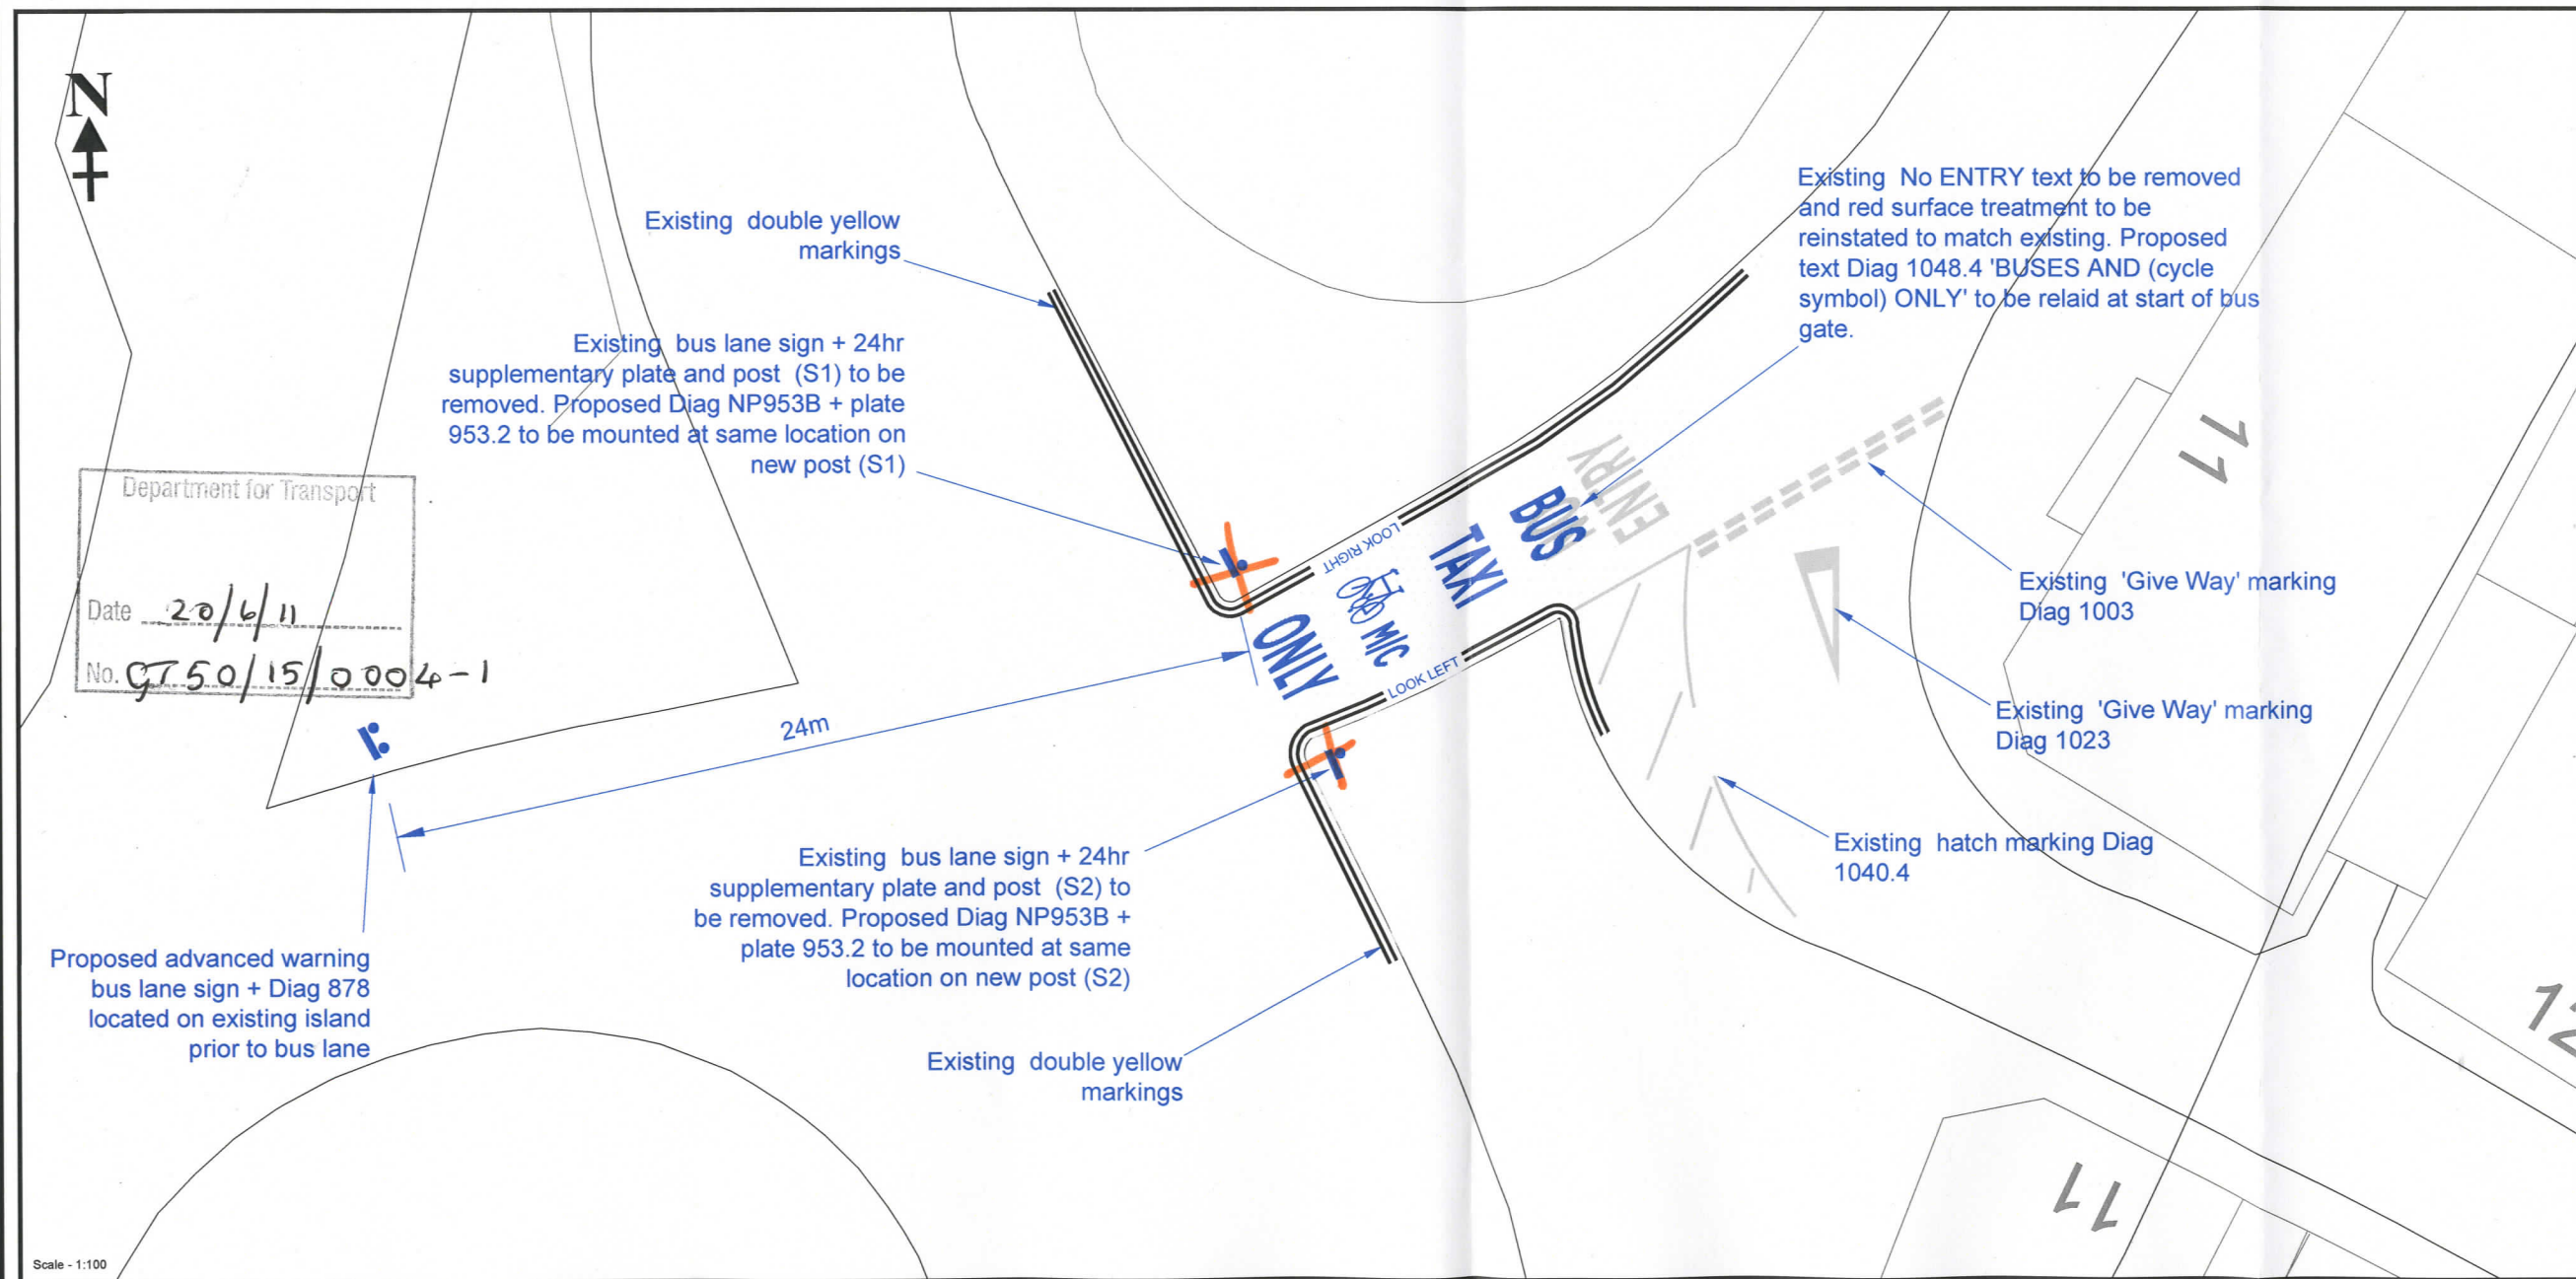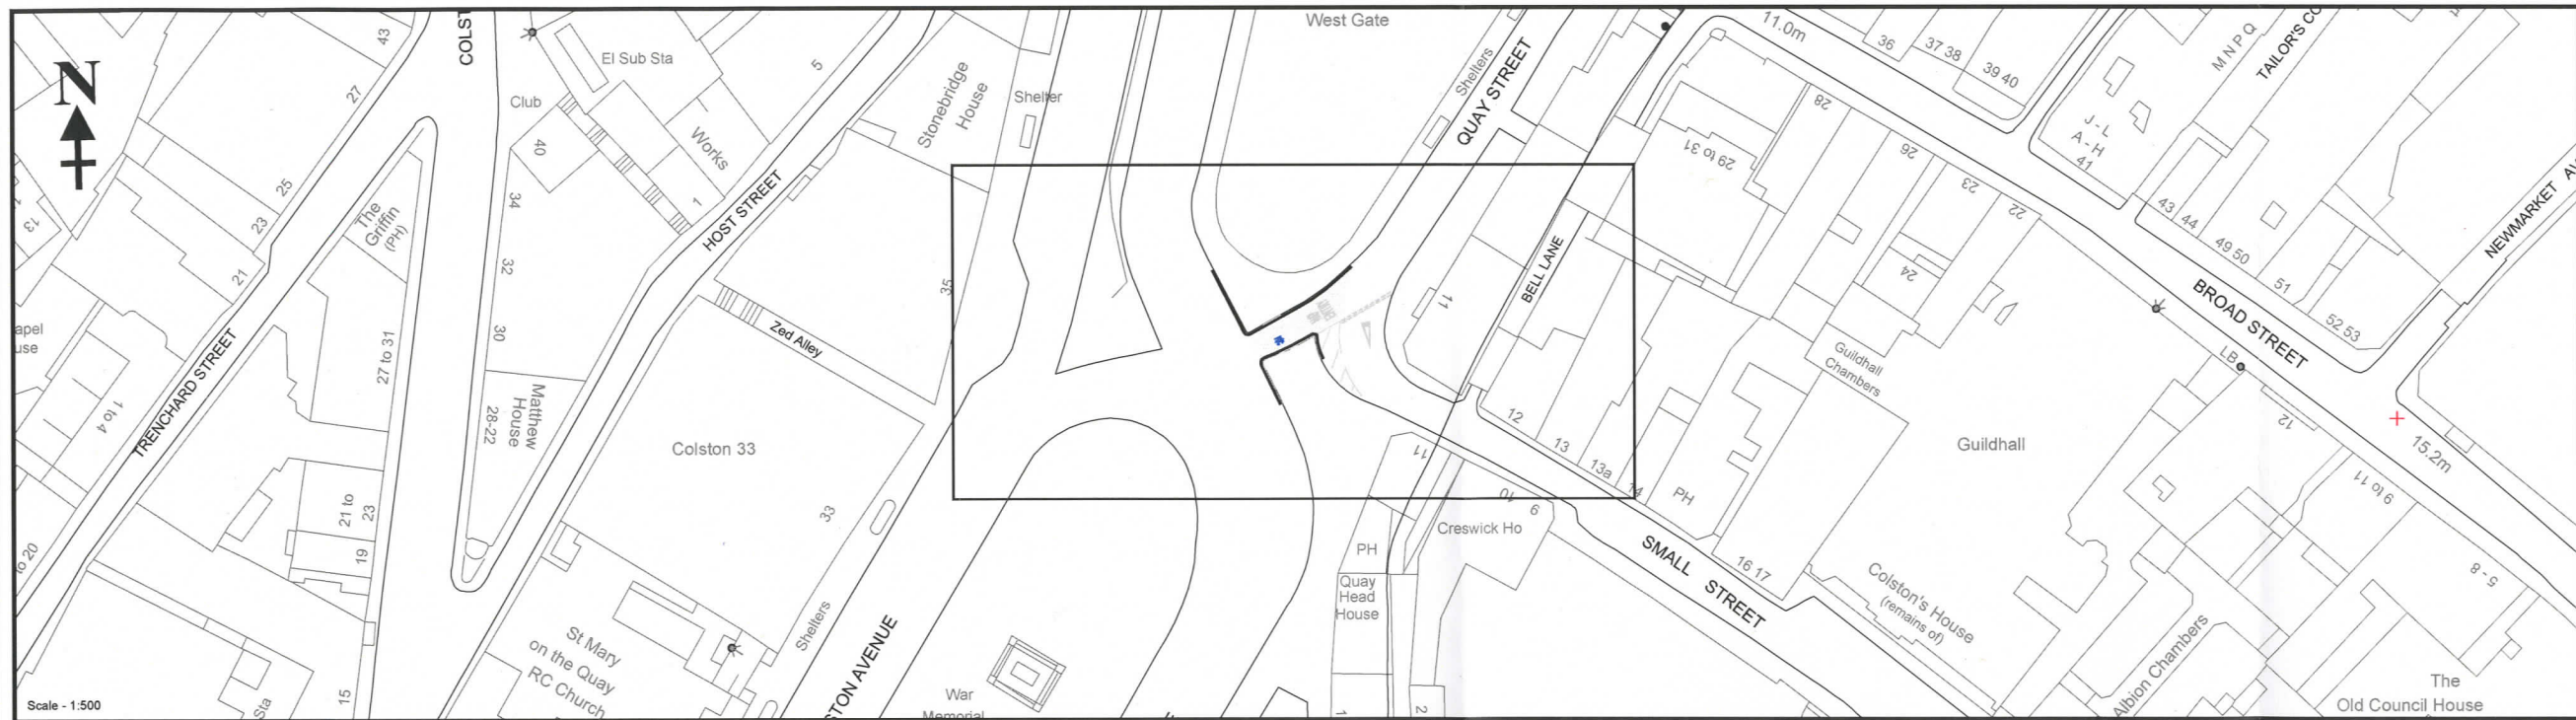

Due to existing road layout the Advanced Warning Sign has not been placed 45m from start of bus lane as described in Ch1 para 4 - Traffic Signs Manual

NOTES
HOURS OF OPERATION:
At Any Time

SPEED LIMIT ON ALL ROADS **30**

ALL NEW SIGNS ARE REFLECTORISED WITH CLASS RA2 (BS12899-1:2007) SIGN FACE MATERIAL

Proposed
Position of other road markings

This map is reproduced from Ordnance Survey material with permission of Ordnance Survey on behalf of the Controller of Her Majesty's Stationary Office (c) Crown copyright. Unauthorised reproductions infringe Crown copyright and may lead to prosecution or civil proceedings. Bristol City Council. Licence No. 10023460

BRISTOL ENGINEERING CONSULTANCY

Brunel House, St Georges Road, Bristol BS1 5UY

Tel: 0117 9222000 Fax: 0117 9223765
E-mail: engineering.consultancy@bristol.gov.uk

Rev.	Date	Description	By
C	28/03/11	minor alterations	CLP
B	22/03/11	Bus lane sign amended	CLP
A	30/11/10	Minor sign amendments	CLP

Project
Bus Lane Survey

Title
Quay Street Bus lane

Client
Alan Berridge, Traffic Management

Project Manager
Mike McNamara
Telephone Number
0117 92 23124
Drawn by
CLP
Date Drawn
May 2010


Scale
As Shown @ A1
Checked by
CLP
Date Issued
CLP
Issued by
CLP

STATUS
☐ Preliminary ☐ Tender ☐ Construction ☐ As Built

DRAWING NUMBER

Project Number
DC0490 - Drawing
590 - Revision
C

- NOTES:
1. The legend is from the Transport Medium alphabet at the x-height shown.
 2. Details of the symbols are given on drawings S 24, S 25 sheet 1 and S 26.
 3. The tile outlines do not form part of the sign.
 4. COLOURS : Background ----- BLUE
Border & Symbols ---- WHITE
'taxi' ----- WHITE
 5. The bus symbol may be varied to the 'local bus' symbol shown on drawing S 25 sheet 2.

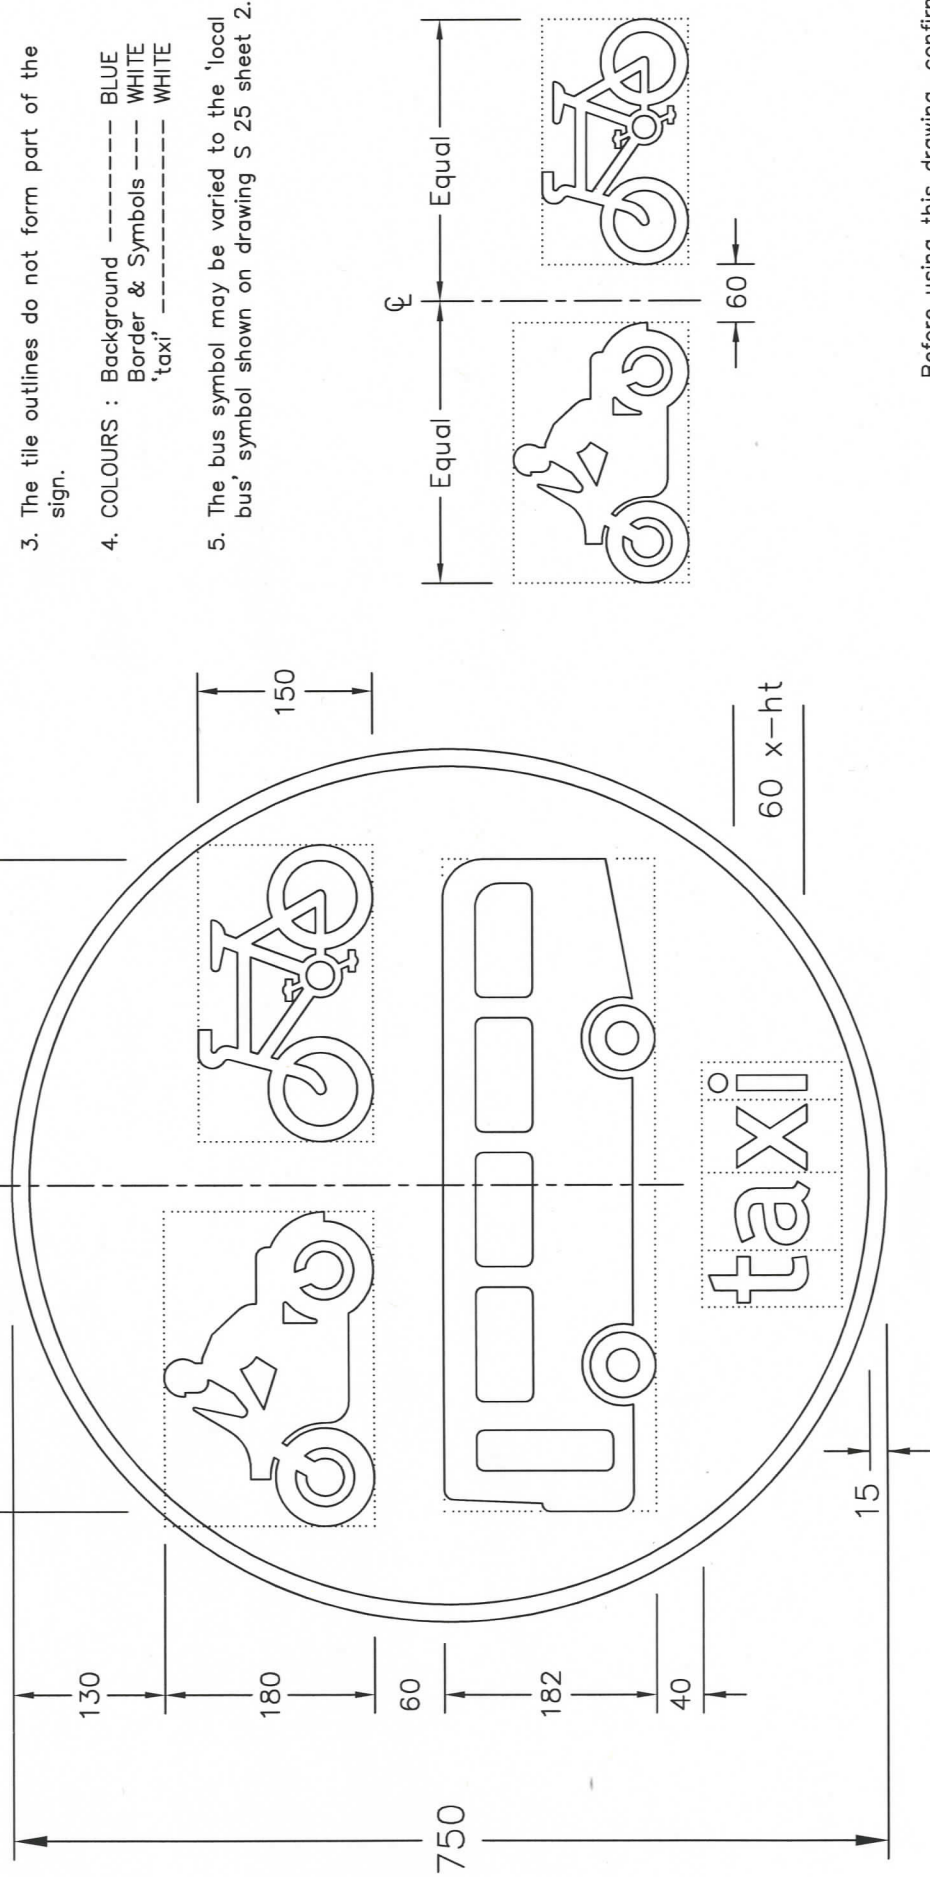

Before using this drawing, confirm that it has not been superseded.

NP953B

<div>Department for</div> <div>Transport</div>	<div>Title:</div> <div>BUS, SOLO MOTOR CYCLE, CYCLE and TAXI ROUTE</div>	<div>Regulatory Sign</div>		<div>Issue:</div> <div>A: 31.5.06</div> <div>B:</div> <div>C:</div>	<div>Drawn by:</div> <div>R.M.</div> <div>Approved by:</div> <div>R.M.</div>	<div>Dimensions:</div> <div>MILLIMETRES</div>	<div>Drawing No.</div> <div>NP 953B</div>