



GT50/024/0038

**ROAD TRAFFIC REGULATION ACT 1984 – SECTIONS 64 AND 65
AUTHORISATION OF TRAFFIC SIGNS AND SPECIAL DIRECTIONS**

The Secretary of State for Transport, in exercise of her powers under Sections 64 and 65 of the Road Traffic Regulation Act 1984, and of all other powers enabling her in that behalf, for the purpose of assisting in the free flow of vehicular traffic at the junction of Oxford Street, Park Street, and Portman Street in the City of Westminster, hereby:-

1. authorises the placing at or within the vicinity of the site shown on the attached plan numbered GT50/024/0038-1 of a traffic sign consisting of a road marking (hereinafter referred to as "the authorised marking") conforming as to size, colour and character with that shown in diagram 1043 in Schedule 6 to the Traffic Signs Regulations 2002 (Part I of SI 2002/3113, "the 2002 Regulations"), save that the overall size and shape of the authorised marking shall be as shown on the said plan; and
2. directs, without prejudice to any statutory provision to the like effect, that it is a condition of this authorisation that the placing of the authorised marking at or near the said site shall continue to have effect only until such day as may be appointed by one month's notice given by the Secretary of State in writing to the traffic authority for the removal or alteration of the authorised marking and on that day the said authorisation shall, without prejudice to the giving of any further authorisation or direction, cease to have effect.

Section 36 of the Road Traffic Act 1988 shall apply to the authorised marking as it applies to the marking shown in diagram 1043 in Schedule 6 to the 2002 Regulations.




GT50/024/0038


The provisions of Regulations 12 and 31 of the 2002 Regulations shall apply to the authorised marking in the same manner as they apply to the marking shown in diagram 1043 in Schedule 6 to those Regulations.

Dated *10 May* 2012


Signed by authority of the Secretary of State

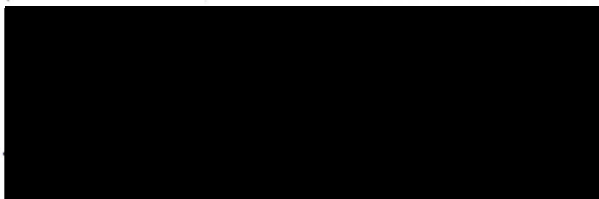

A Delegated Official of the Department for Transport

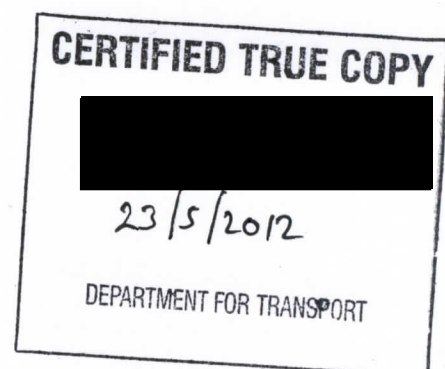

c:\DSB\BRIEF\10564600 - DSB 422 Parking Advice\11676909 - DSB 422 2010_2011\11676909 - 001 B1 xxxxxx - Traffic Signs Manual\Author\11677034-014-Z-01.dwg 06 Mar, 2012 - 2:40pm

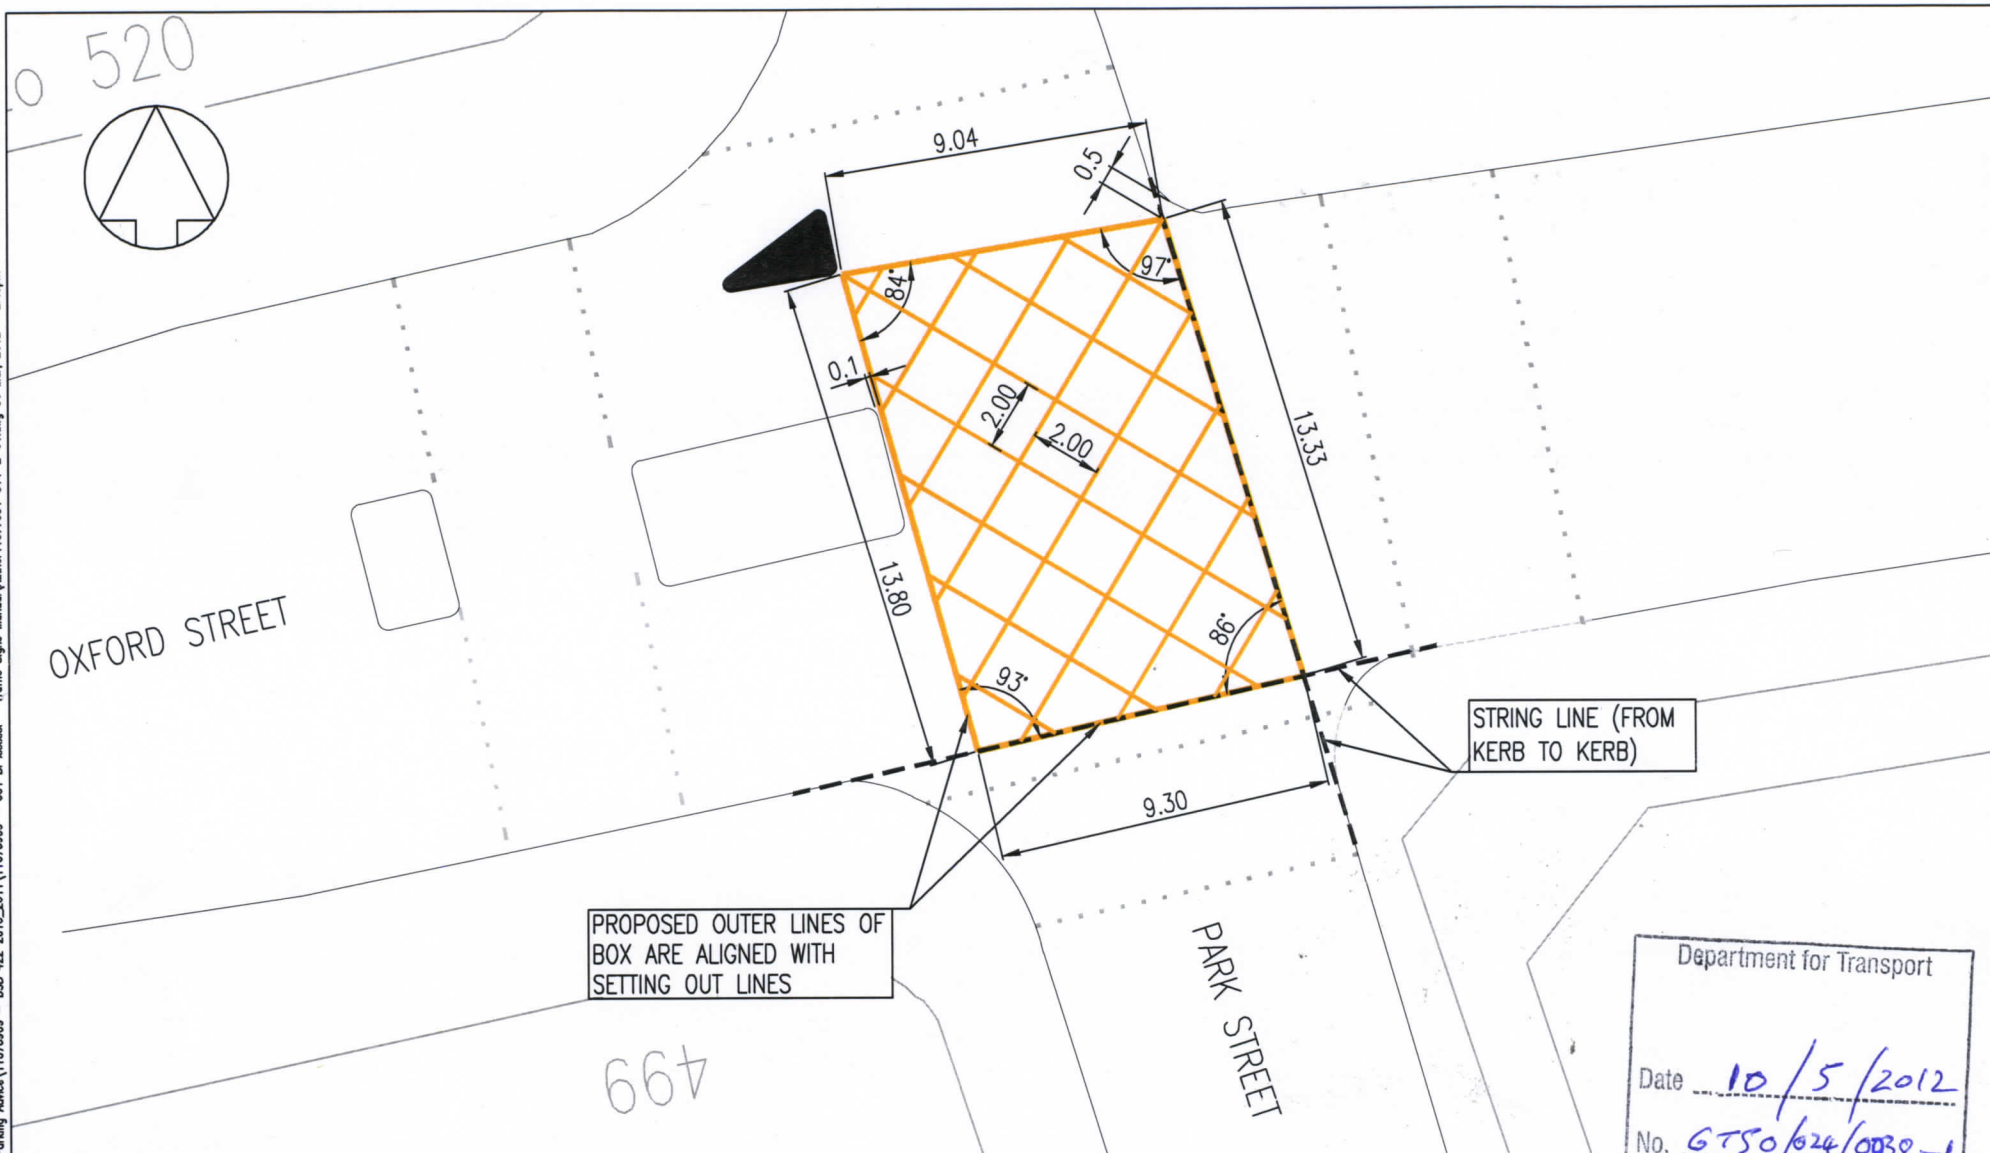

© Crown copyright. All rights reserved City of Westminster LA 100019597

WEST ONE

West One Infrastructure Services
10th Floor 64 Victoria Street London SW1E 6QP
Tel: +44 (0) 20 7811 6300 Fax: +44 (0) 20 7811 6301
<http://www.westonejv.co.uk>

CLIENT:


City of Westminster
SAFE STREETS
City Commissioner of Transportation

PROJECT:

PORTMAN STREET &
PARK STREET JUNCTION

TITLE:

DfT APPROVAL FOR
YELLOW BOX JUNCTION

A	13.02.2012	TA	EMERGING GREEN	CHKD	APPRO	SCALE @ A4L	DATE	DESIGN/DRN	CAD CHECKED	CHECKED	APPROVED/SHT
REV	DATE	BY	DESCRIPTION	CHK	APD	1:200	25.01.12	AK/MC	MC	JWH	AK A4L
DRAWING STATUS:						JOB No. -					
AS BUILT						DRAWING No. 11677034-014-Z-01					
						REV: A					

Department for Transport

Date 10/5/2012

No. GTSO/024/0089-1

BRIEF/DSB No. BR xxxxx