



**ROAD TRAFFIC REGULATION ACT 1984 - SECTIONS 64 AND 65
AUTHORISATION OF TRAFFIC SIGNS AND SPECIAL DIRECTIONS**

The Secretary of State for Transport, in exercise of his powers under Sections 64 and 65 of the Road Traffic Regulation Act 1984, and of all other powers enabling him in that behalf, for the purpose of controlling traffic flow at the junction of Ilkeston Road and Church Street in Heanor, Derbyshire, hereby:-

1. authorises the erection at or within 2 metres of the site marked "48" on the attached plan numbered GT50/034/0012-1 of a light signal (hereinafter referred to as "the authorised light signal") conforming as to size, colour and character with diagram 3000 in Schedule 8 to the Traffic Signs Regulations 2002 (Part I of S.I. 2002/3113, "the 2002 Regulations"), save that the authorised light signal may be used in conjunction with a push button (hereinafter referred to as the "authorised push button") conforming as to size, colour and character with only that part of diagram 4003.1 in Schedule 9 to the 2002 Regulations, as amended by the Traffic Signs (Amendment) (No. 2) Regulations 2011 (Part 1 of S.I. 2011/3041, "the 2011 Regulations"), which includes the push button and the legend above it; and
2. directs that the authorised light signal and the authorised push button may only be placed at the said site if the apparatus (including the content of all instructions stored in it) used in connection with it is of a type which has been approved by the Secretary of State as appropriate to the site and application; and
3. directs, without prejudice to any statutory provision to the like effect, that it is a condition of this authorisation that the erection of the authorised light signal and the authorised push button at or near the said sites shall continue to have effect only until such day as may be appointed by one month's notice given by the Secretary of State in writing to the traffic authority for the removal or alteration of the authorised light signal and the authorised push button and on that day the said authorisation shall, without prejudice to the giving of any further authorisation or direction, cease to have effect; and




 
4. directs that, notwithstanding anything to the contrary contained in the preceding paragraph, the authorised light signal and the authorised push button shall be retained no later than 12 months from the date of this authorisation.

The provisions of Regulations 12 and 33 of the 2002 Regulations shall apply to the authorised light signal in the same manner as they apply to the light signal to diagram 3000 in Schedule 8 to those Regulations.



The provisions of Regulations 12 and 33 of the 2002 Regulations shall apply to the authorised push button in the same manner as they apply to the light signal to diagram 4003.1 in Schedule 9 to those Regulations as amended by the 2011 Regulations.

Dated 12 August 2014

Signed by authority of the Secretary of State

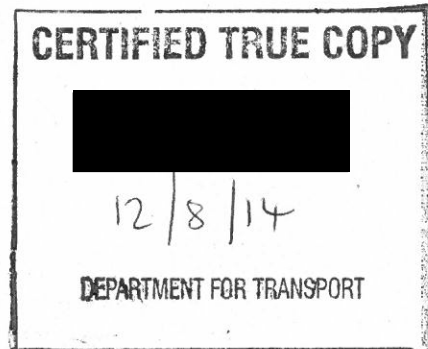


.....
A Delegated Official of the Department for Transport

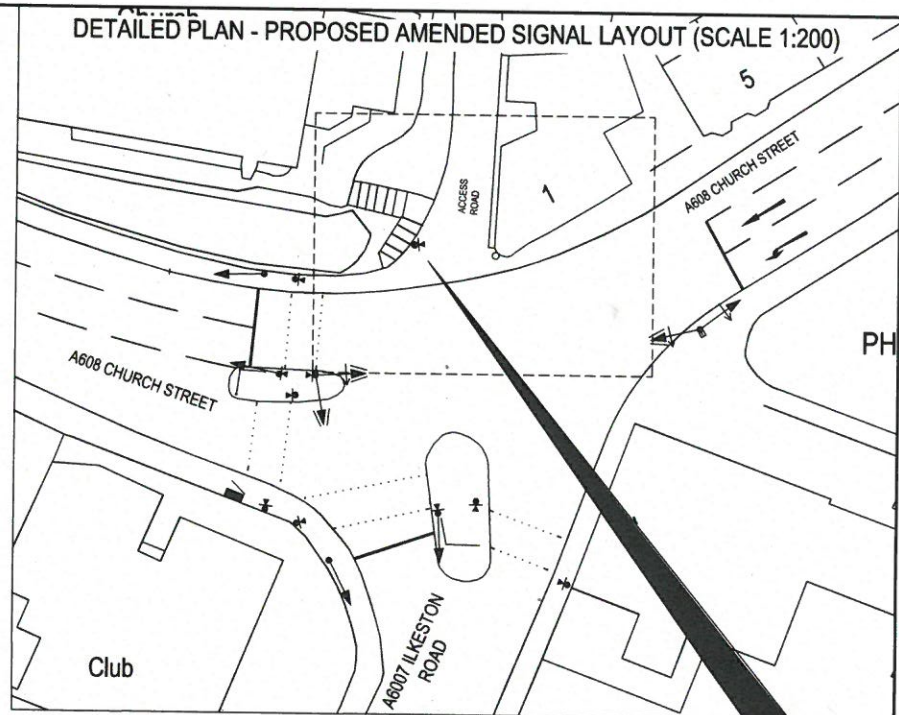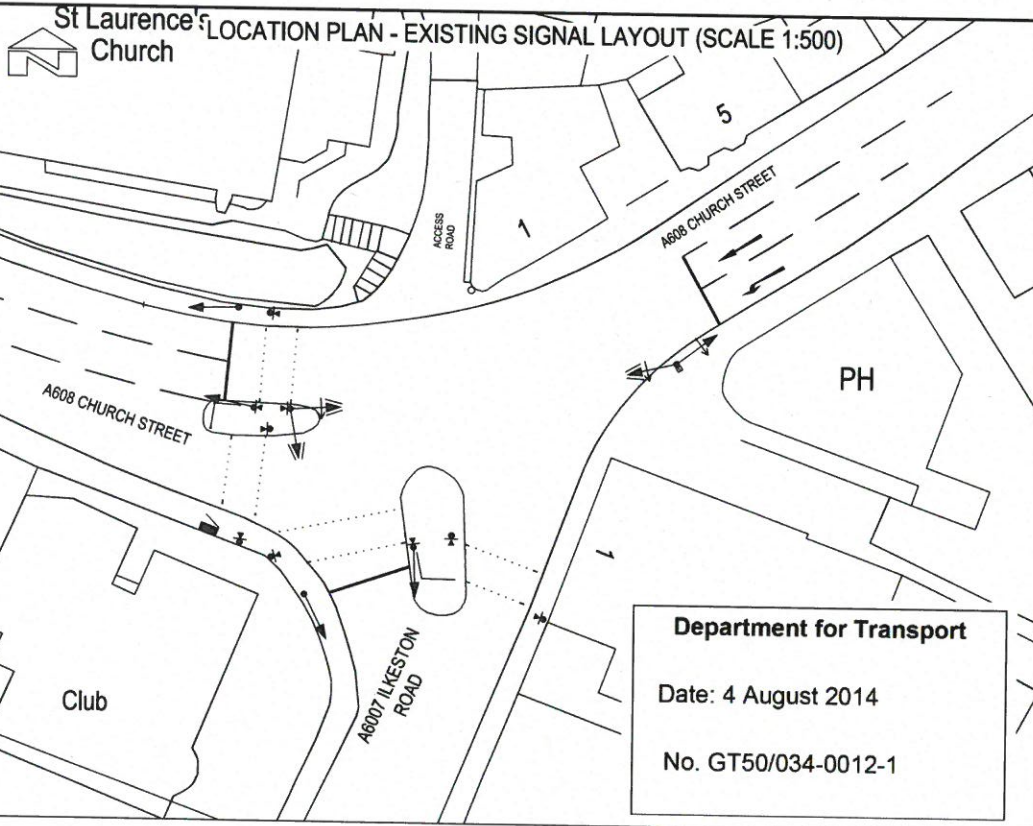


Department for Transport
 Date: 4 August 2014
 No. GT50/034-0012-1

STAGE DIAGRAM

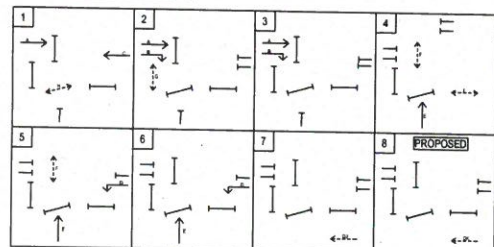


LINK DIAGRAM

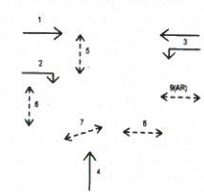

NOTES:-

- Proposed Push Button unit on pole 4B will call stage 8 "All Red" and run for a period of 7 seconds, allowing a vehicle to safely exit the access..
- The Push Button unit will illuminate until stage 8 is running.

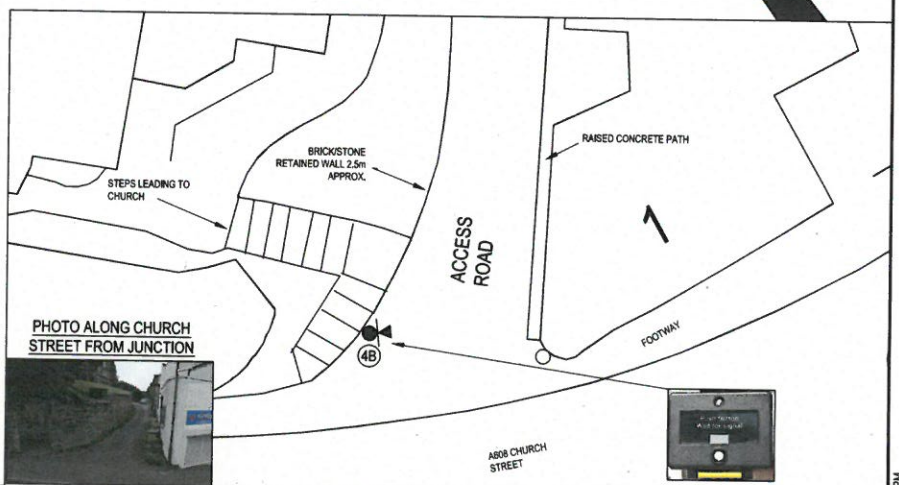

© Crown copyright and database rights 2014. Ordnance Survey 100023251.
 You are not permitted to copy, sub-licence, distribute or sell any of this data to third parties in any form.



MIKE ASHWORTH
 Strategic Director - Economy, Transport and Environment

AMENDMENTS TO DRAWING PROFILE		MH	DA	DA	22/03/14	F
PUSH BUTTON		JRB	DA	DA	20/03/14	E
INSTALLATION OF NEW SIGNAL POLE PROPOSED AT EXIT FROM PRIVATE DRIVE TO ALLOW THE INSTALLATION OF ADDITIONAL PUSH BUTTON UNIT TO DEMAND ALL RED STAGE 7.		JH	-	-	29/01/14	D
MOVA UPGRADE		MH	-	-	29/02/11	C
AS BUILT DETAILS		WH	-	-	02/06	B
AS BUILT DETAILS		IMW	-	-	05/00	A
AMENDMENT DETAILS		BY	CHKD	APVD	DATE	NO.

PROJECT TITLE		DATE	DATE	DATE
CHURCH SQUARE, HEANOR TRAFFIC SIGNALS		22/07/14	22/07/14	22/07/14
DRAWING TITLE		DATE	DATE	DATE
PROPOSED SIGNALISED ACCESS ON EXISTING SIGNALLED JUNCTION		22/07/14	22/07/14	22/07/14

DRAWN	CHECKED	APPROVED	SCALE
MH	DA	DA	AS_SHOWN
Date	Date	Date	
22/07/14	22/07/14	22/07/14	
Project / Confirm Reference No. HEANOR-CHURCH_SQUARE			
Drawing Number TA308/2/H5/1F			
ORIGINAL DRAWING SIZE (A1 x 504 (A1))			