



Department
for Transport

Road Traffic Regulation Act 1984

Sections 64 and 65

Authorisation of traffic signs and special directions

Accessible transcript

Secretary of State for Transport's traffic authorisation of traffic signs for the purpose of giving directions to road users near the A2 Bean and Ebbsfleet junction, and where National Highways is the traffic authority.

The following pages contain a copy of the text from the Secretary of State for Transport's traffic authorisation regarding the above traffic signs.

A scanned copy of the signed authorisation and supporting documents from the application are appended to this letter. The supporting material is submitted to the Department for Transport by a third party. You should refer to the party involved for accessible copies of the supporting material.



**ROAD TRAFFIC REGULATION ACT 1984 – SECTIONS 64 AND 65
AUTHORISATION OF TRAFFIC SIGNS AND SPECIAL DIRECTIONS**

The Secretary of State for Transport, in exercise of her powers under Sections 64 and 65 of the Road Traffic Regulation Act 1984, and all other powers enabling her in that behalf for the purpose of giving directions to road users near the A2 Bean and Ebbsfleet junction, and where National Highways is the traffic authority, hereby:-

1. authorises the erection at or within 5 metres of the site shown schematically on the attached plan numbered GT50/198/0123-1 of a traffic sign (hereinafter referred to as “the authorised sign A”) conforming as to size, colour and character with that shown on the attached drawing numbered GT50/198/0123-2; and
2. authorises the erection at or within 5 metres of the site shown schematically on the attached plan numbered GT50/198/0123-3 of a traffic sign (hereinafter referred to as “the authorised sign B”) conforming as to size, colour and character with that shown on the attached drawing numbered GT50/198/0123-4; and
3. directs, without prejudice to any statutory provisions to the like effect, that it is a condition of this authorisation that the erection of the authorised signs A and B at or near the said sites shall continue to have effect only until such day as may be appointed by one month's notice given by the Secretary of State in writing to the traffic authority for the removal or alteration of the authorised signs A and B and on that day the said authorisation shall, without prejudice to the giving of any further authorisation or direction, cease to have effect.

The provisions of Regulations 5, 6, 7, 8 and 11 of the Traffic Signs Regulations 2016 (Part 1 of S.I. 2016/362, “the 2016 Regulations”) shall apply to the authorised sign A in the same manner as they apply to the sign shown in Schedule 12, Part 28, Item 2 to those Regulations.



The provisions of Schedule 12, Parts 1 to 29 of the 2016 Regulations shall apply to the authorised sign A in the same manner as they apply to the sign shown in Schedule 12, Part 28, Item 2 to those Regulations.

The provisions of Regulations 5, 6, 7, 8 and 11 of the 2016 Regulations shall apply to the authorised sign B in the same manner as they apply to the sign shown in Schedule 12, Part 2, Item 2 to those Regulations.

The provisions of Schedule 12, Parts 1 to 29 of the 2016 Regulations shall apply to the authorised sign B in the same manner as they apply to the sign shown in Schedule 12, Part 2, Item 2 to those Regulations.

Dated *08 December 2025*

Signed by authority of the Secretary of State

.....
A Delegated Official of the Department for Transport



Department
for Transport

SCANNED AUTHORISATION AND SUPPORTING DOCUMENTS FOLLOW



**ROAD TRAFFIC REGULATION ACT 1984 – SECTIONS 64 AND 65
AUTHORISATION OF TRAFFIC SIGNS AND SPECIAL DIRECTIONS**

The Secretary of State for Transport, in exercise of her powers under Sections 64 and 65 of the Road Traffic Regulation Act 1984, and all other powers enabling her in that behalf for the purpose of giving directions to road users near the A2 Bean and Ebbsfleet junction, and where National Highways is the traffic authority, hereby:-

1. authorises the erection at or within 5 metres of the site shown schematically on the attached plan numbered GT50/198/0123-1 of a traffic sign (hereinafter referred to as “the authorised sign A”) conforming as to size, colour and character with that shown on the attached drawing numbered GT50/198/0123-2; and
2. authorises the erection at or within 5 metres of the site shown schematically on the attached plan numbered GT50/198/0123-3 of a traffic sign (hereinafter referred to as “the authorised sign B”) conforming as to size, colour and character with that shown on the attached drawing numbered GT50/198/0123-4; and
3. directs, without prejudice to any statutory provisions to the like effect, that it is a condition of this authorisation that the erection of the authorised signs A and B at or near the said sites shall continue to have effect only until such day as may be appointed by one month's notice given by the Secretary of State in writing to the traffic authority for the removal or alteration of the authorised signs A and B and on that day the said authorisation shall, without prejudice to the giving of any further authorisation or direction, cease to have effect.

The provisions of Regulations 5, 6, 7, 8 and 11 of the Traffic Signs Regulations 2016 (Part 1 of S.I. 2016/362, “the 2016 Regulations”) shall apply to the authorised sign A in the same manner as they apply to the sign shown in Schedule 12, Part 28, Item 2 to those Regulations.



Department for Transport

GT50/198/0123

 
The provisions of Schedule 12, Parts 1 to 29 of the 2016 Regulations shall apply to the authorised sign A in the same manner as they apply to the sign shown in Schedule 12, Part 28, Item 2 to those Regulations.

The provisions of Regulations 5, 6, 7, 8 and 11 of the 2016 Regulations shall apply to the authorised sign B in the same manner as they apply to the sign shown in Schedule 12, Part 2, Item 2 to those Regulations.

The provisions of Schedule 12, Parts 1 to 29 of the 2016 Regulations shall apply to the authorised sign B in the same manner as they apply to the sign shown in Schedule 12, Part 2, Item 2 to those Regulations.


Dated *08 December 2025*

Signed by authority of the Secretary of State



.....
A Delegated Official of the Department for Transport

CERTIFIED TRUE COPY

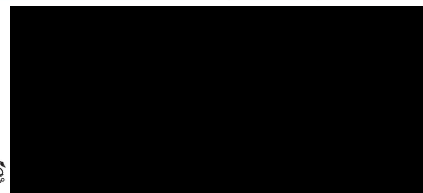

Department
for Transport


Date:
11/12/2025

DO NOT SCALE

0 10 100
Millimetres

FOR CONTINUATION
REFER TO SHEET 3

FOR CONTINUATION
REFER TO SHEET 5

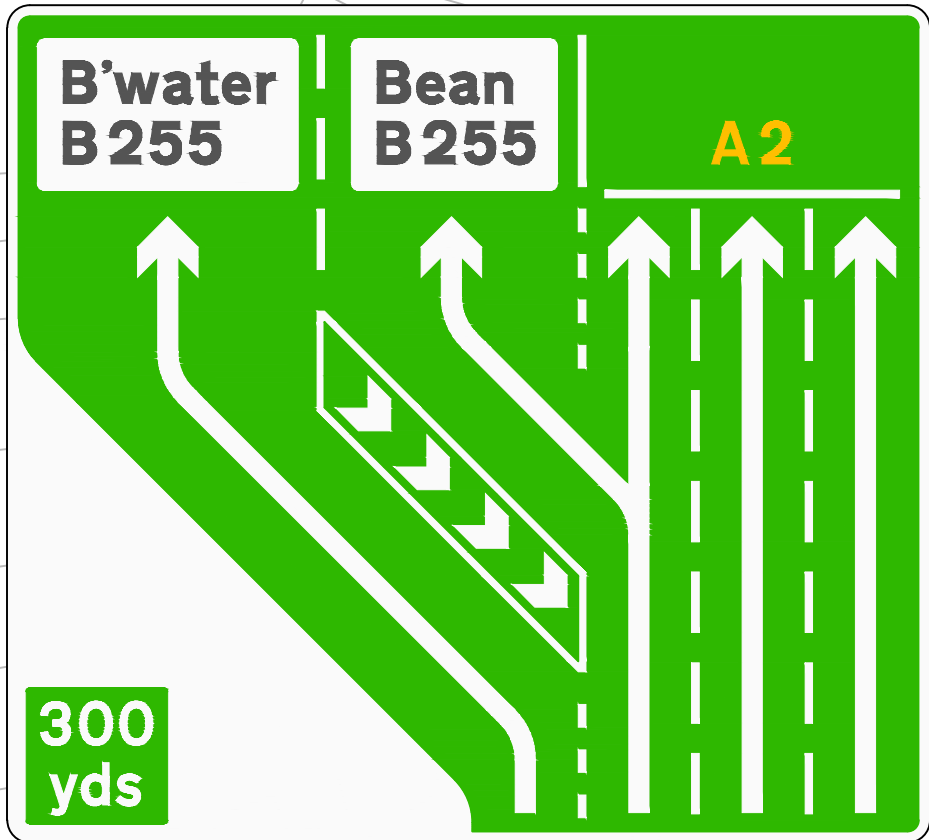

P-A2-004
LOCATED AT MP 30/4A + 23

EXISTING ROAD MARKINGS
RETAINED FROM THIS
POINT WESTWARDS IN
THESE 2 LANES

SEE INSET




Department
for Transport

Date: 05 December 2025

Number: GT50/198/0123-1


This map is based on Ordnance Survey material with the permission of Ordnance Survey on behalf of the Controller of Her Majesty's Stationery Office. © Crown copyright. Unauthorised reproduction infringes Crown copyright and may lead to prosecution or civil proceedings.
Highways England 100030946, 2020.

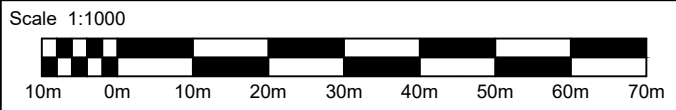

NOTES:

- DO NOT SCALE FROM THIS DRAWING.
- SEE DRAWING
HE543917-BBA-HSN-A2_ML-DE-CH-000001 FOR SIGN
FACE DETAILS.

KEY PLAN
Scale: N.T.S.

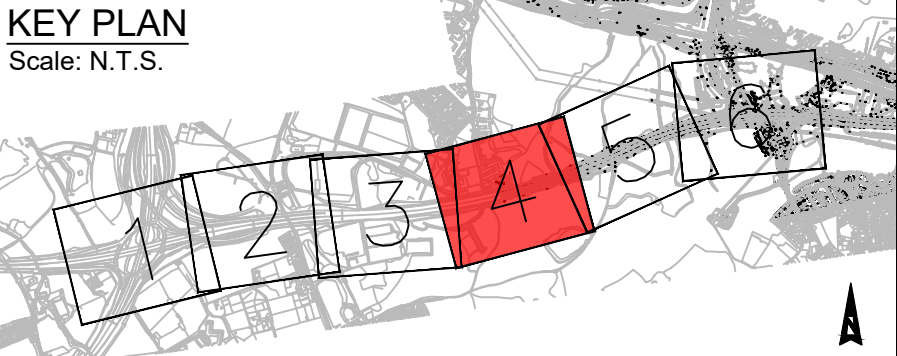

Description

Status	Revision	Drawn	Checked	Reviewed	Authorised	Issue Date
--------	----------	-------	---------	----------	------------	------------

Description

Status	Revision	Drawn	Checked	Reviewed	Authorised	Issue Date
--------	----------	-------	---------	----------	------------	------------

Description

Status	Revision	Drawn	Checked	Reviewed	Authorised	Issue Date
--------	----------	-------	---------	----------	------------	------------

FOR INFORMATION

Status	Revision	Drawn	Checked	Reviewed	Authorised	Issue Date
S3	P01	SS	SD	EBB	EBB	26/05/23

AS BUILT - P-A2-004 AMENDED

Status	Revision	Drawn	Checked	Reviewed	Authorised	Issue Date
S3	P02	SS	SD	SD	EBB	05/09/24

Drawing Suitability	Status	QR Code
FOR REVIEW / COMMENT	S3	

Designer

ATKINS
Member of the SNC-Lavalin Group
Woodcote Grove, Ashley Road, Epsom, Surrey,
KT18 5BW
Tel:+44 (0)1372 726140
Fax:+44 (0)1372 740055
www.atkinsglobal.com
Copyright © SNC Lavalin (2019)

Delivery Partner

Balfour Beatty
Atkins Offices
Woodcote Grove
Ashley Road
Epsom
Surrey
KT18 5BW
www.balfourbeatty.com

Client



Project Title
A2 Bean and Ebbsfleet
Junction Improvements

Drawing Title
NON-PREScribed SIGNS
LOCATION PLAN



Drawing Number	Project	Originator	Volume
HE543917	BBA	HSN	
Location	Type	Role	Number
A2_ML_SCHME_A	DR	CH	000004
Original Size	Scale	Project Ref. No.	Sheet
A1	AS SHOWN		4 of 6
			Rev: P02



Department
for Transport

Date: 05 December 2025

Number: GT50/198/0123-2

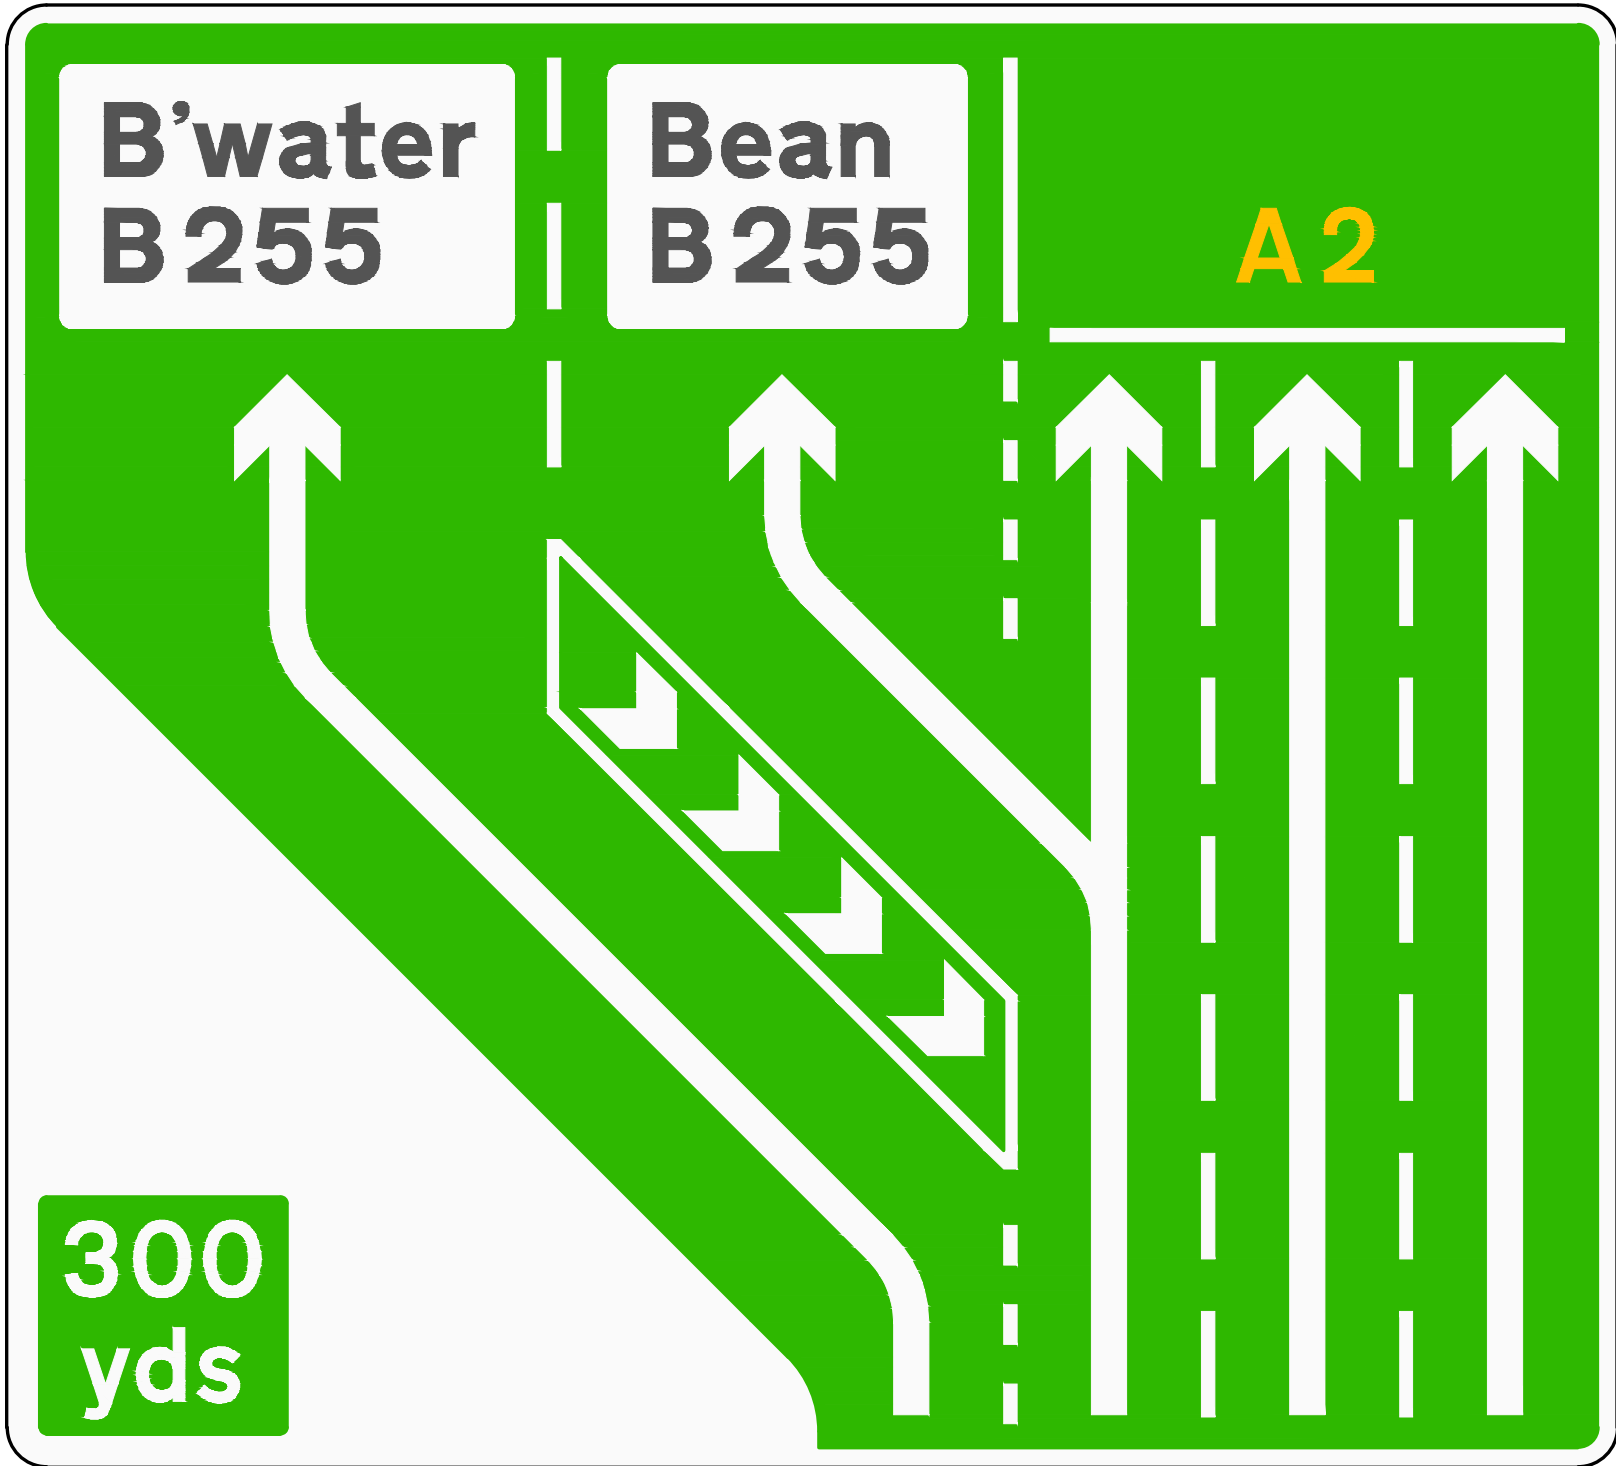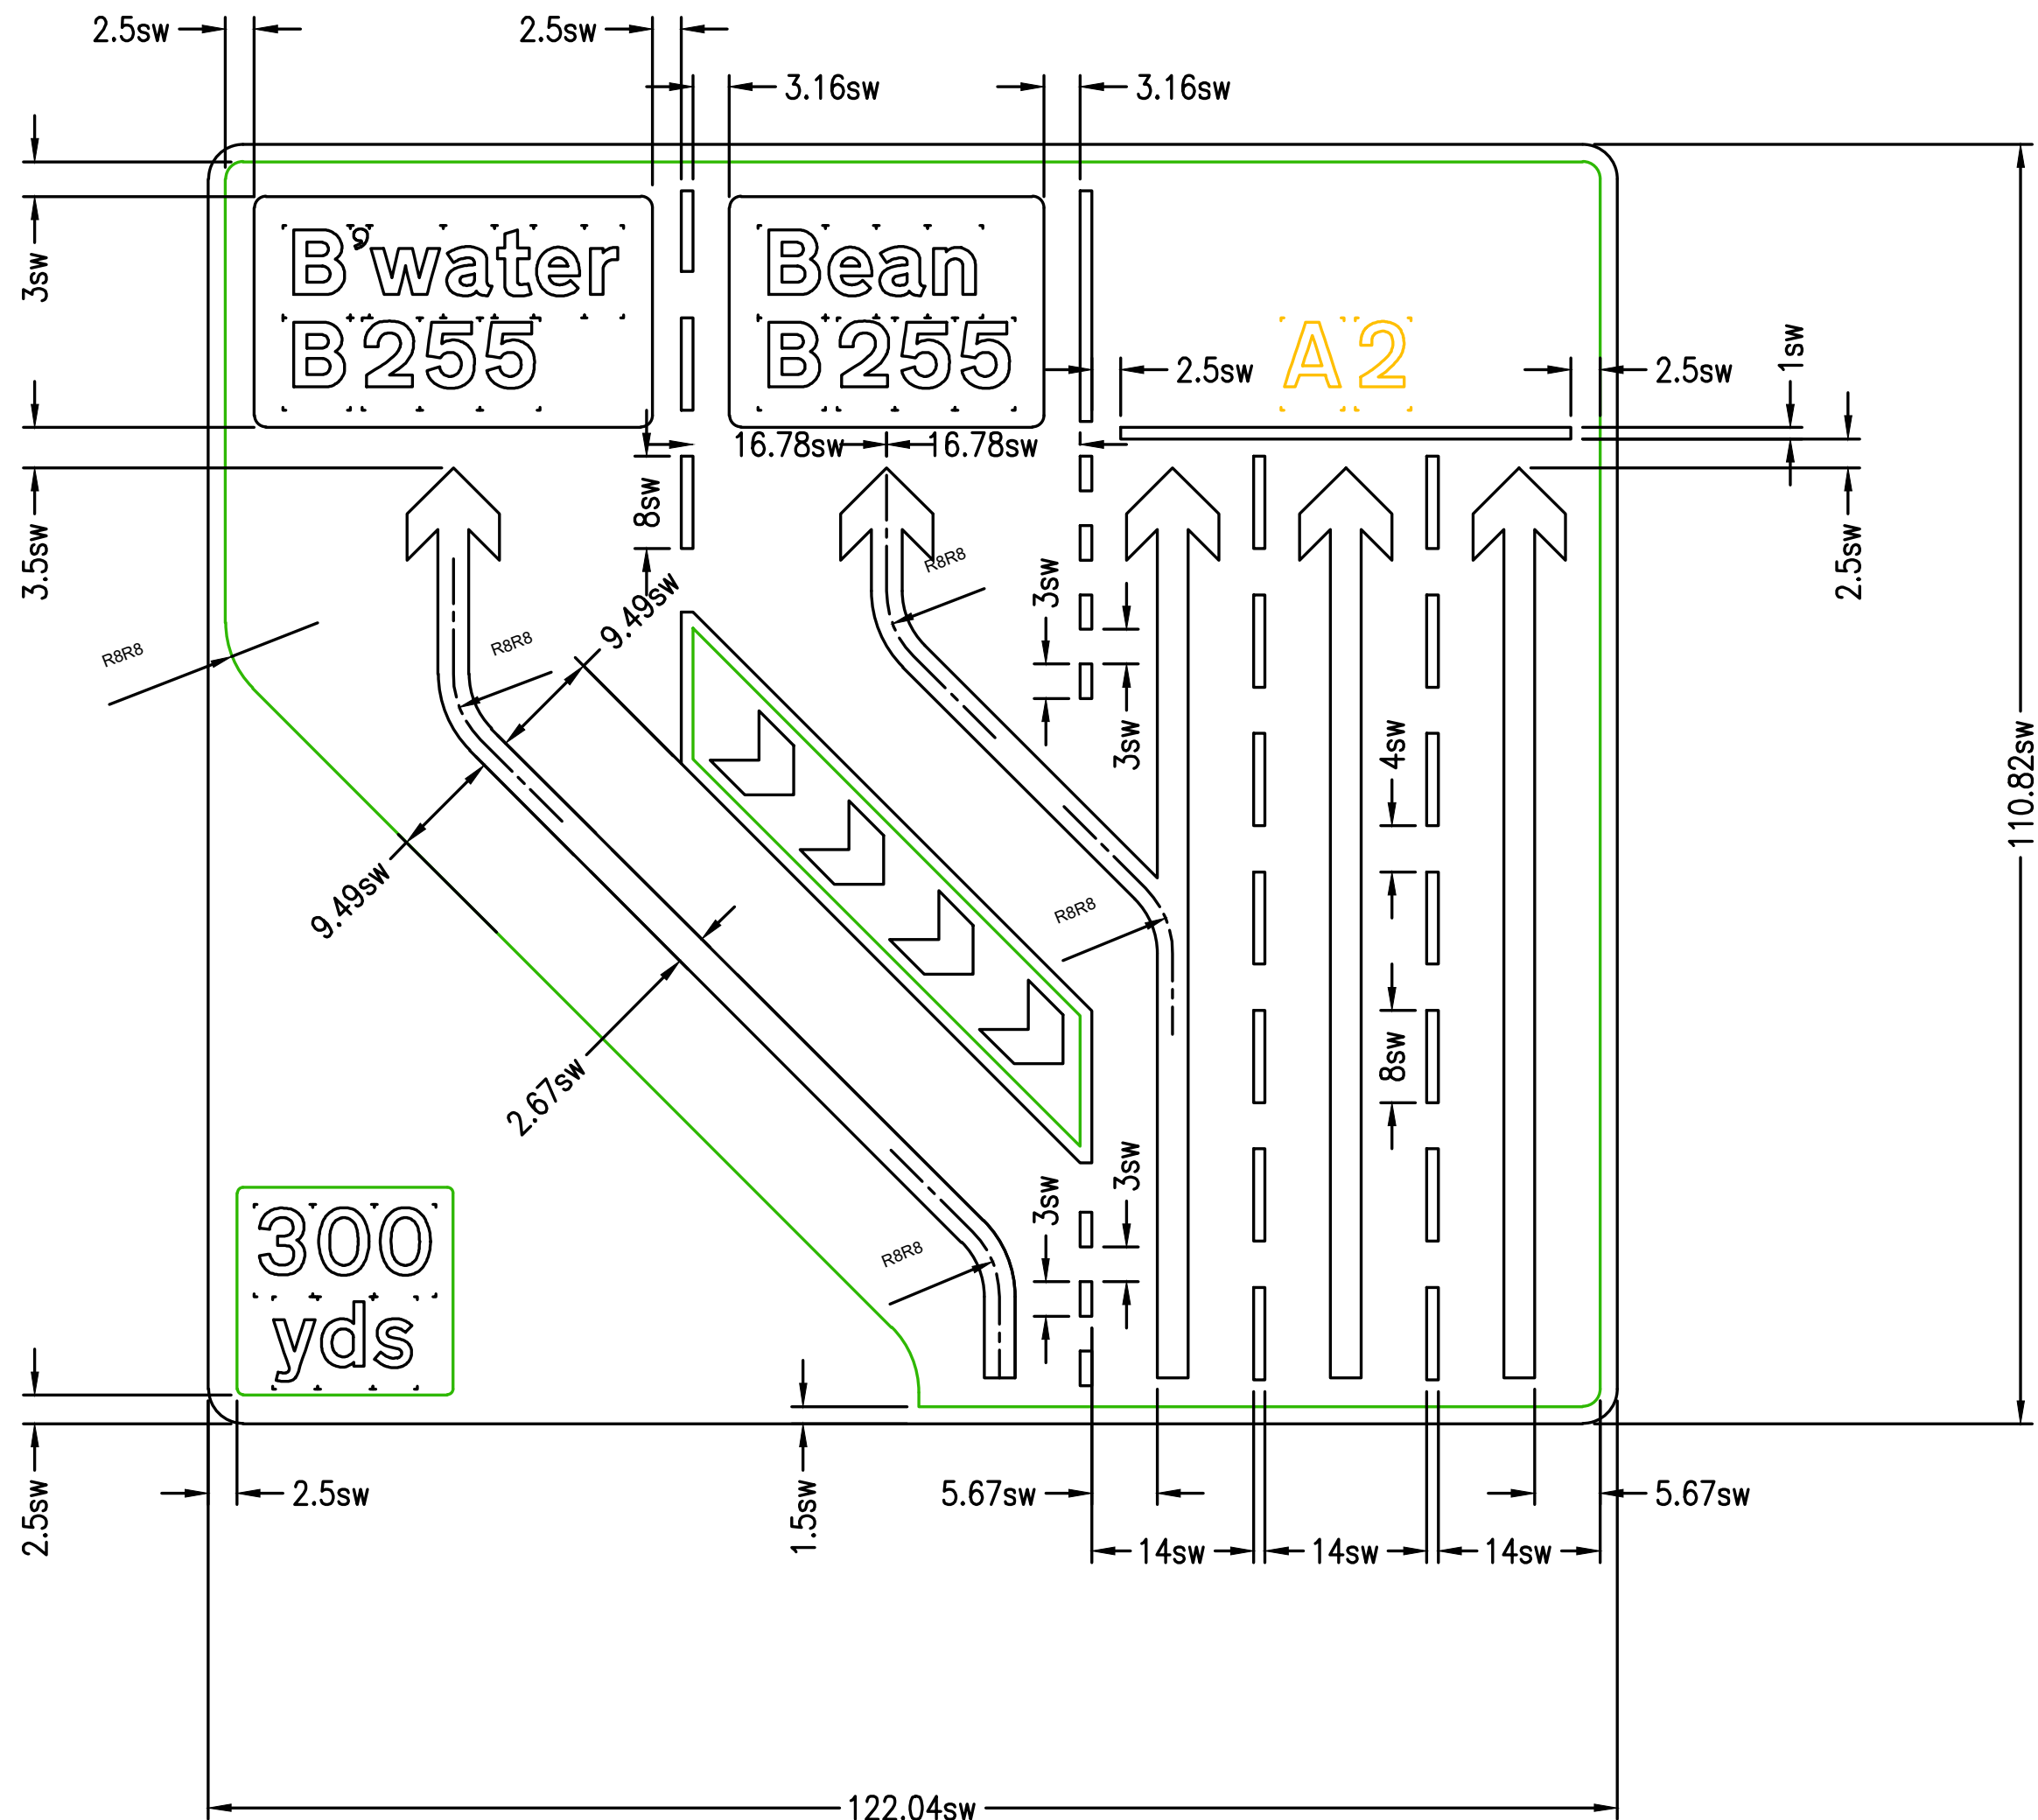

Signing Project	A2 BEAN					
Sign Reference	P-A2-004	Width (mm)	4575	Background	Green	
x Height	150.0	Height (mm)	4155	Border	White	
Material	Class RA2	Area (m²)	19.01	Legend	White	

NOTES:

- DO NOT SCALE FROM THIS DRAWING.
- SEE DRAWING HE543917-BBA-HSN-A2_ML_SCHME_A-DR-CH-000001 FOR LOCATION PLAN.

SAFETY, HEALTH AND ENVIRONMENTAL
INFORMATION

In addition to the hazards/risks normally associated with the types of work detailed on this drawing, note the following significant residual risks (Reference shall also be made to the design hazard log).

Construction
REFER TO HEALTH AND SAFETY RISK REGISTER DOCUMENT No: HE543917-BBA-GHS-WHL_AL_SCHME-HS-ZS-000003

Maintenance / Cleaning
REFER TO HEALTH AND SAFETY RISK REGISTER DOCUMENT No: HE543917-BBA-GHS-WHL_AL_SCHME-HS-ZS-000003

Use
REFER TO HEALTH AND SAFETY RISK REGISTER DOCUMENT No: HE543917-BBA-GHS-WHL_AL_SCHME-HS-ZS-000003

Decommissioning / Demolition
REFER TO HEALTH AND SAFETY RISK REGISTER DOCUMENT No: HE543917-BBA-GHS-WHL_AL_SCHME-HS-ZS-000003

Description

Status	Revision	Drawn	Checked	Reviewed	Authorised	Issue Date
--------	----------	-------	---------	----------	------------	------------

Description

Status	Revision	Drawn	Checked	Reviewed	Authorised	Issue Date
--------	----------	-------	---------	----------	------------	------------

Description

P-A2-004

DO NOT SCALE

Millimetres

0

10

100

FOR CONTINUATION
REFER TO SHEET 3

FOR CONTINUATION
REFER TO SHEET 5

EXISTING ROAD MARKINGS
RETAINED FROM THIS
POINT WESTWARDS IN
THESE 2 LANES

SEE INSET

210
yds

Greenhithe
Bluewater
B255

Bean B255

A & E

(M2)

Dover, Canterbury A2


GN-A2A-03
LOCATED AT MP 30/4A + 93

NOTES:

- DO NOT SCALE FROM THIS DRAWING.
- SEE DRAWING
HE543917-BBA-HSN-A2_ML-DE-CH-000001 FOR SIGN
FACE DETAILS.

KEY PLAN

Scale: N.T.S.

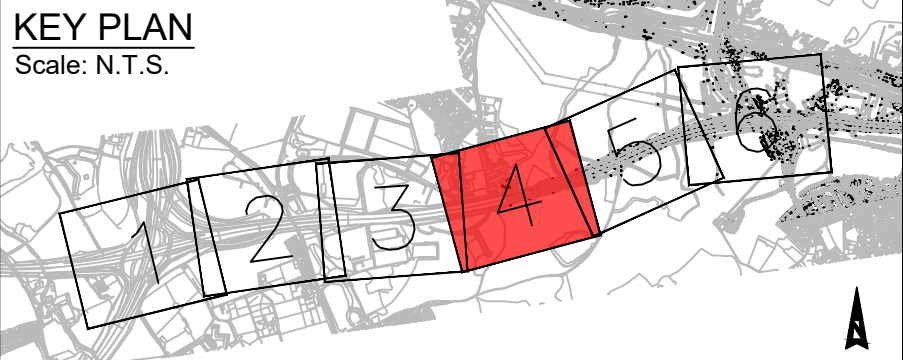

Description

Status	Revision	Drawn	Checked	Reviewed	Authorised	Issue Date
--------	----------	-------	---------	----------	------------	------------

Description

Status	Revision	Drawn	Checked	Reviewed	Authorised	Issue Date
--------	----------	-------	---------	----------	------------	------------

Description

Status	Revision	Drawn	Checked	Reviewed	Authorised	Issue Date
--------	----------	-------	---------	----------	------------	------------

FOR INFORMATION

Status	Revision	Drawn	Checked	Reviewed	Authorised	Issue Date
S3	P01	SS	SD	EBB	EBB	26/05/23

Description

AS BUILT - P-A2-004 AMENDED

Status	Revision	Drawn	Checked	Reviewed	Authorised	Issue Date
S3	P02	SS	SD	SD	EBB	05/09/24

Drawing Suitability

FOR REVIEW / COMMENT

S3

QR Code

Designer

ATKINS

Member of the SNC-Lavalin Group
Woodcote Grove, Ashley Road, Epsom, Surrey,
KT18 5BW
Tel:+44 (0)1372 726140
Fax:+44 (0)1372 740055

www.atkinsglobal.com
Copyright © SNC Lavalin (2019)

Delivery Partner

Balfour Beatty

Atkins Offices
Woodcote Grove
Ashley Road
Epsom
Surrey
KT18 5BW
www.balfourbeatty.com

Client



Project Title

A2 Bean and Ebbsfleet
Junction Improvements

Drawing Title

NON-PREScribed SIGNS
LOCATION PLAN

Drawing Number

Project HE543917 Originator BBA Volume HSN
A2_ML_SCHME_A DR CH 000004

Location

Type Role Number

Original

Size: A1

Scale

AS SHOWN

Project

Ref. No.

Sheet

4 of 6

Rev

P02



Department
for Transport


Date: 05 December 2025

Number: GT50/198/0123-3

Scale 1:1000



This map is based on Ordnance Survey material with the permission of
Ordnance Survey on behalf of the Controller of Her Majesty's Stationery
Office. © Crown copyright. Unauthorised reproduction infringes Crown
copyright and may lead to prosecution or civil proceedings.
Highways England 100039460, 2020.

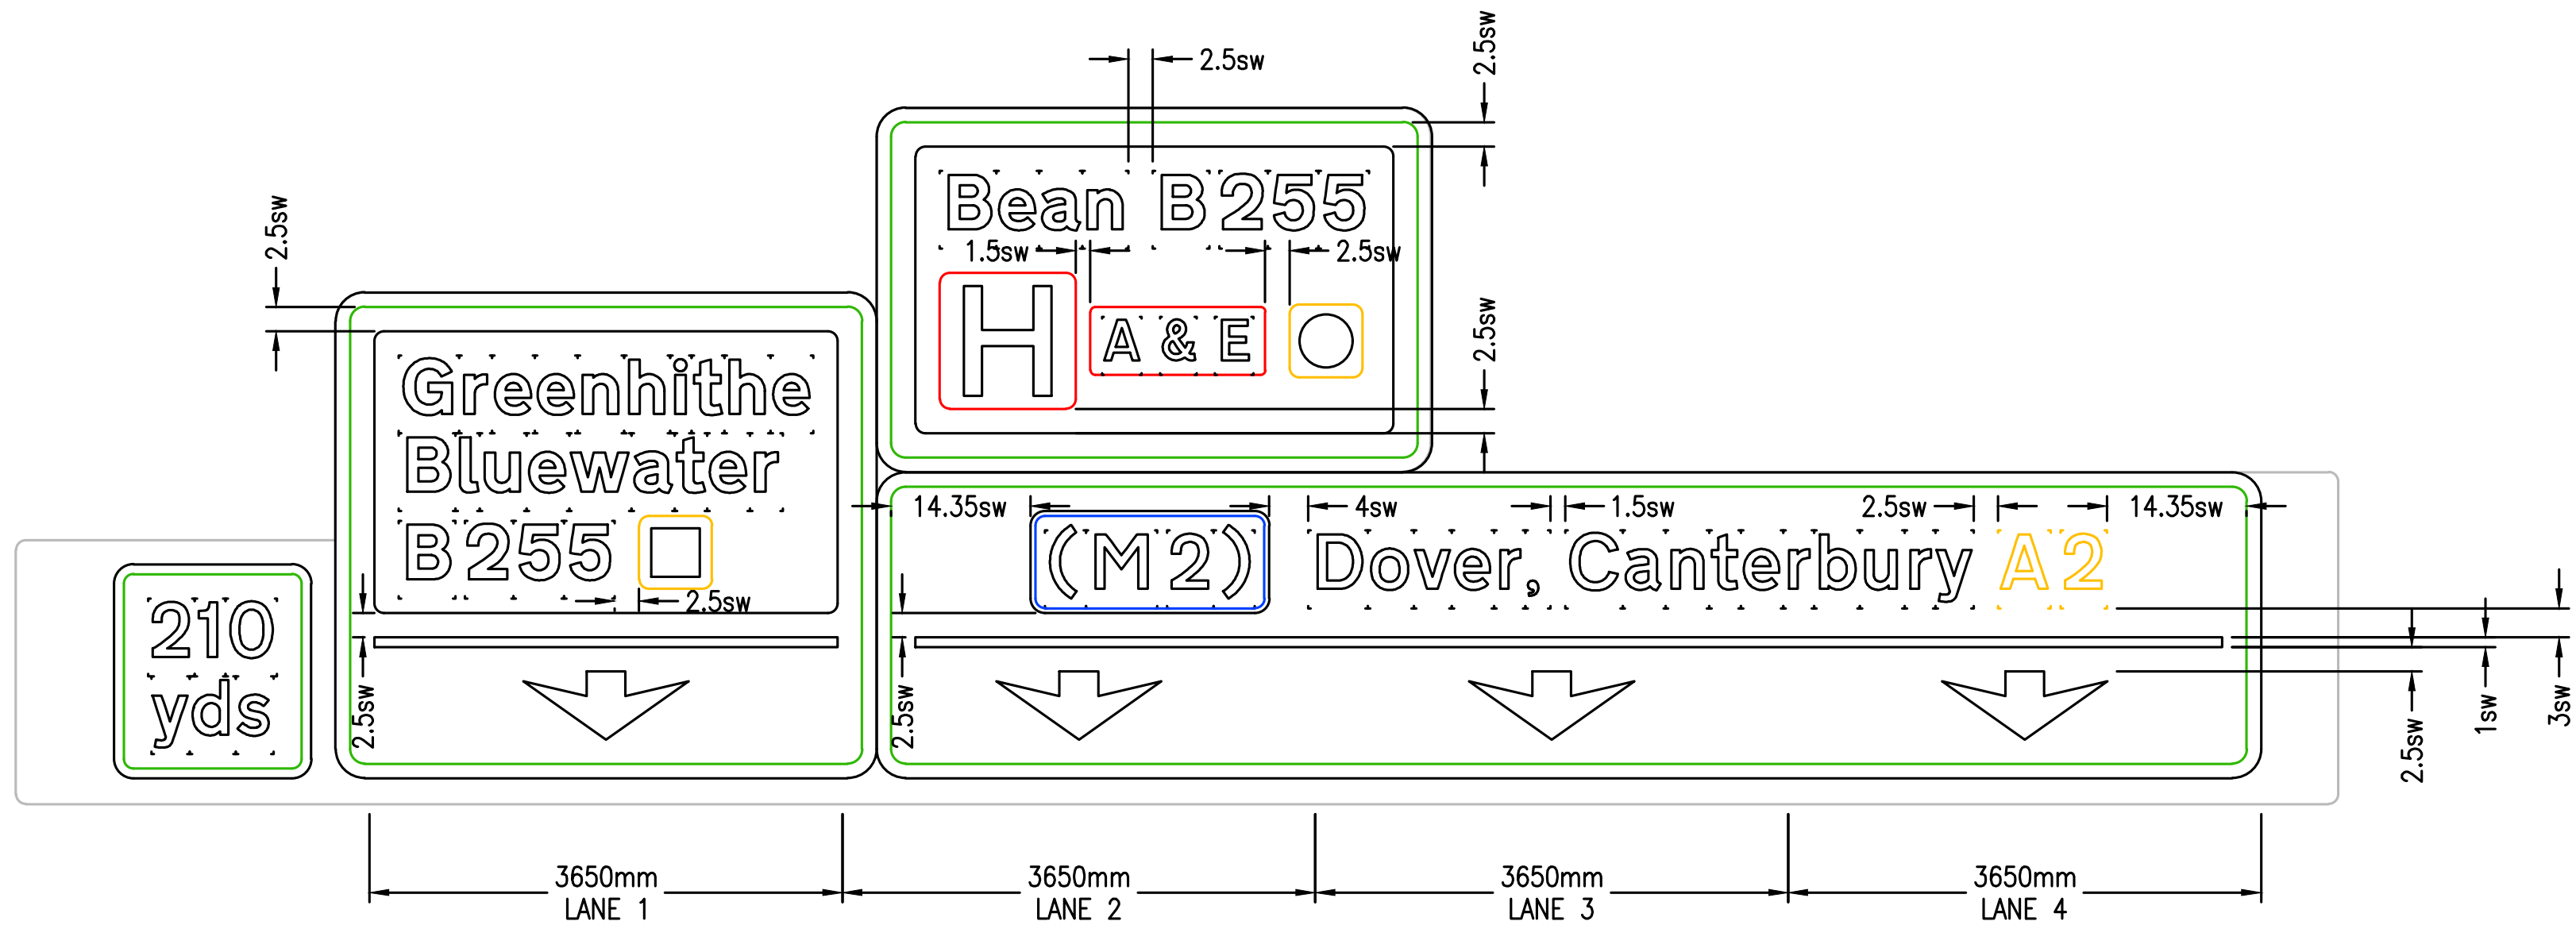


Signing Project	A2 BEAN				
Sign Reference	GN-A2A-03A	Width (mm)	4175	Background	Green
x Height	300.0	Height (mm)	3750	Border	White
Material	Class RA2	Area (m ²)	15.66	Legend	White

Signing Project	A2 BEAN				
Sign Reference	GN-A2A-03B	Width (mm)	4290	Background	Green
x Height	300.0	Height (mm)	2815	Border	White
Material	Class RA2	Area (m ²)	12.08	Legend	White

Signing Project	A2 BEAN				
Sign Reference	GN-A2A-03C	Width (mm)	10685	Background	Green
x Height	300.0	Height (mm)	2365	Border	White
Material	Class RA2	Area (m ²)	25.27	Legend	White

Signing Project	A2 BEAN				
Sign Reference	GN-A2A-03D	Width (mm)	1520	Background	Green
x Height	300.0	Height (mm)	1650	Border	White
Material	Class RA2	Area (m ²)	2.51	Legend	White

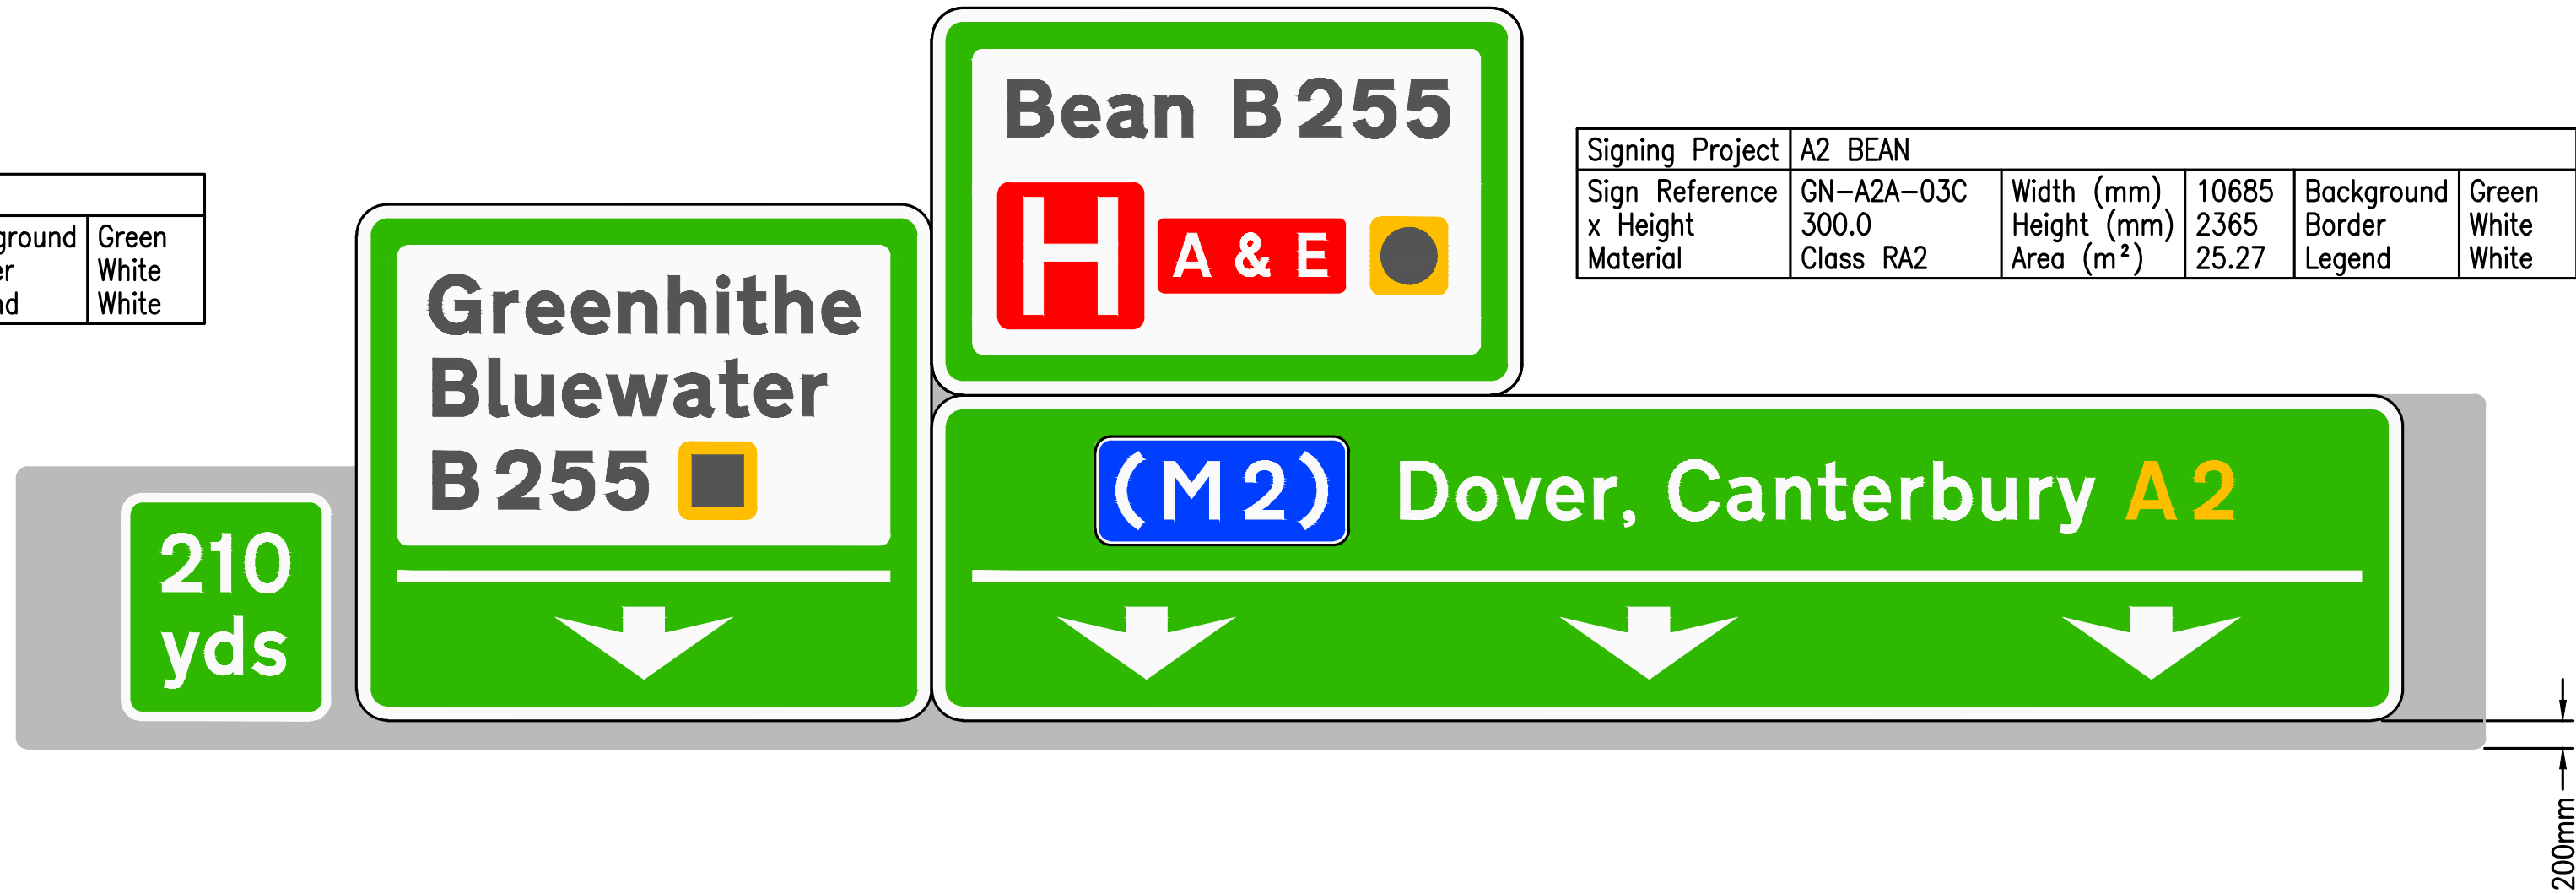

CH 3215, 190m FROM DATUM

GN-A2A-03



Department
for Transport

Date: 05 December 2025

Number: GT50/198/0123-4

NOTES:

- DO NOT SCALE FROM THIS DRAWING.
- SEE DRAWING HE543917-BBA-HSN-A2_ML_SCHEME-A-DR-CH-000001 FOR LOCATION PLAN.

SAFETY, HEALTH AND ENVIRONMENTAL
INFORMATION

In addition to the hazards/risks normally associated with the types of work detailed on this drawing, note the following significant residual risks (Reference shall also be made to the design hazard log).

Construction
REFER TO HEALTH AND SAFETY RISK REGISTER DOCUMENT No: HE543917-BBA-GHS-WHL_AL_SCHEME-HS-ZS-000003

Maintenance / Cleaning
REFER TO HEALTH AND SAFETY RISK REGISTER DOCUMENT No: HE543917-BBA-GHS-WHL_AL_SCHEME-HS-ZS-000003

Use
REFER TO HEALTH AND SAFETY RISK REGISTER DOCUMENT No: HE543917-BBA-GHS-WHL_AL_SCHEME-HS-ZS-000003

Decommissioning / Demolition
REFER TO HEALTH AND SAFETY RISK REGISTER DOCUMENT No: HE543917-BBA-GHS-WHL_AL_SCHEME-HS-ZS-000003

Description

Status	Revision	Drawn	Checked	Reviewed	Authorised	Issue Date
--------	----------	-------	---------	----------	------------	------------

Description

Status	Revision	Drawn	Checked	Reviewed	Authorised	Issue Date
--------	----------	-------	---------	----------	------------	------------

Description

Status	Revision	Drawn	Checked	Reviewed	Authorised	Issue Date
--------	----------	-------	---------	----------	------------	------------

Description

FOR INFORMATION

Status	Revision	Drawn	Checked	Reviewed	Authorised	Issue Date
S3	P01	SS	SD	EBB	EBB	26/05/23

Description

FOR INFORMATION

Status	Revision	Drawn	Checked	Reviewed	Authorised	Issue Date
S3	P02	SS	SD	SD	EBB	05/09/24

Drawing Suitability

Status	QR Code
--------	---------

FOR REVIEW / COMMENT

S3

Designer

ATKINS

Member of the SNC-Lavalin Group

Woodcote Grove, Ashley Road, Epsom, Surrey, KT18 5BW

Tel: +44 (0)1372 726140 Fax: +44 (0)1372 740055

www.atkinsglobal.com

Copyright © SNC Lavalin (2019)

Delivery Partner

Balfour Beatty

Atkins Offices

Woodcote Grove

Ashley Road

Epsom

Surrey

KT18 5BW

www.balfourbeatty.com

Client

**highways
england**

Project Title

A2 Bean and Ebbsfleet

Junction Improvements

Drawing Title

NON-PRESCRIBED SIGNS

Drawing Number

Project HE543917 - BBA - HSN -

A2_ML - DE - CH - 000001

Location

Original Size: A1 Scale: NTS Project Ref. No: Sheet: 1 of 1 Rev: P02